MISSION SANTA BARBARA
46
44
28U964
Seatrain Lines
SEATRAIN CAROLINA
BOAT DECK
UPPER BRIDGE DECK
WALK WAY
BRIDGE SPACE
TONNAGE OPENING
FLOOD

48-49
2-103-1

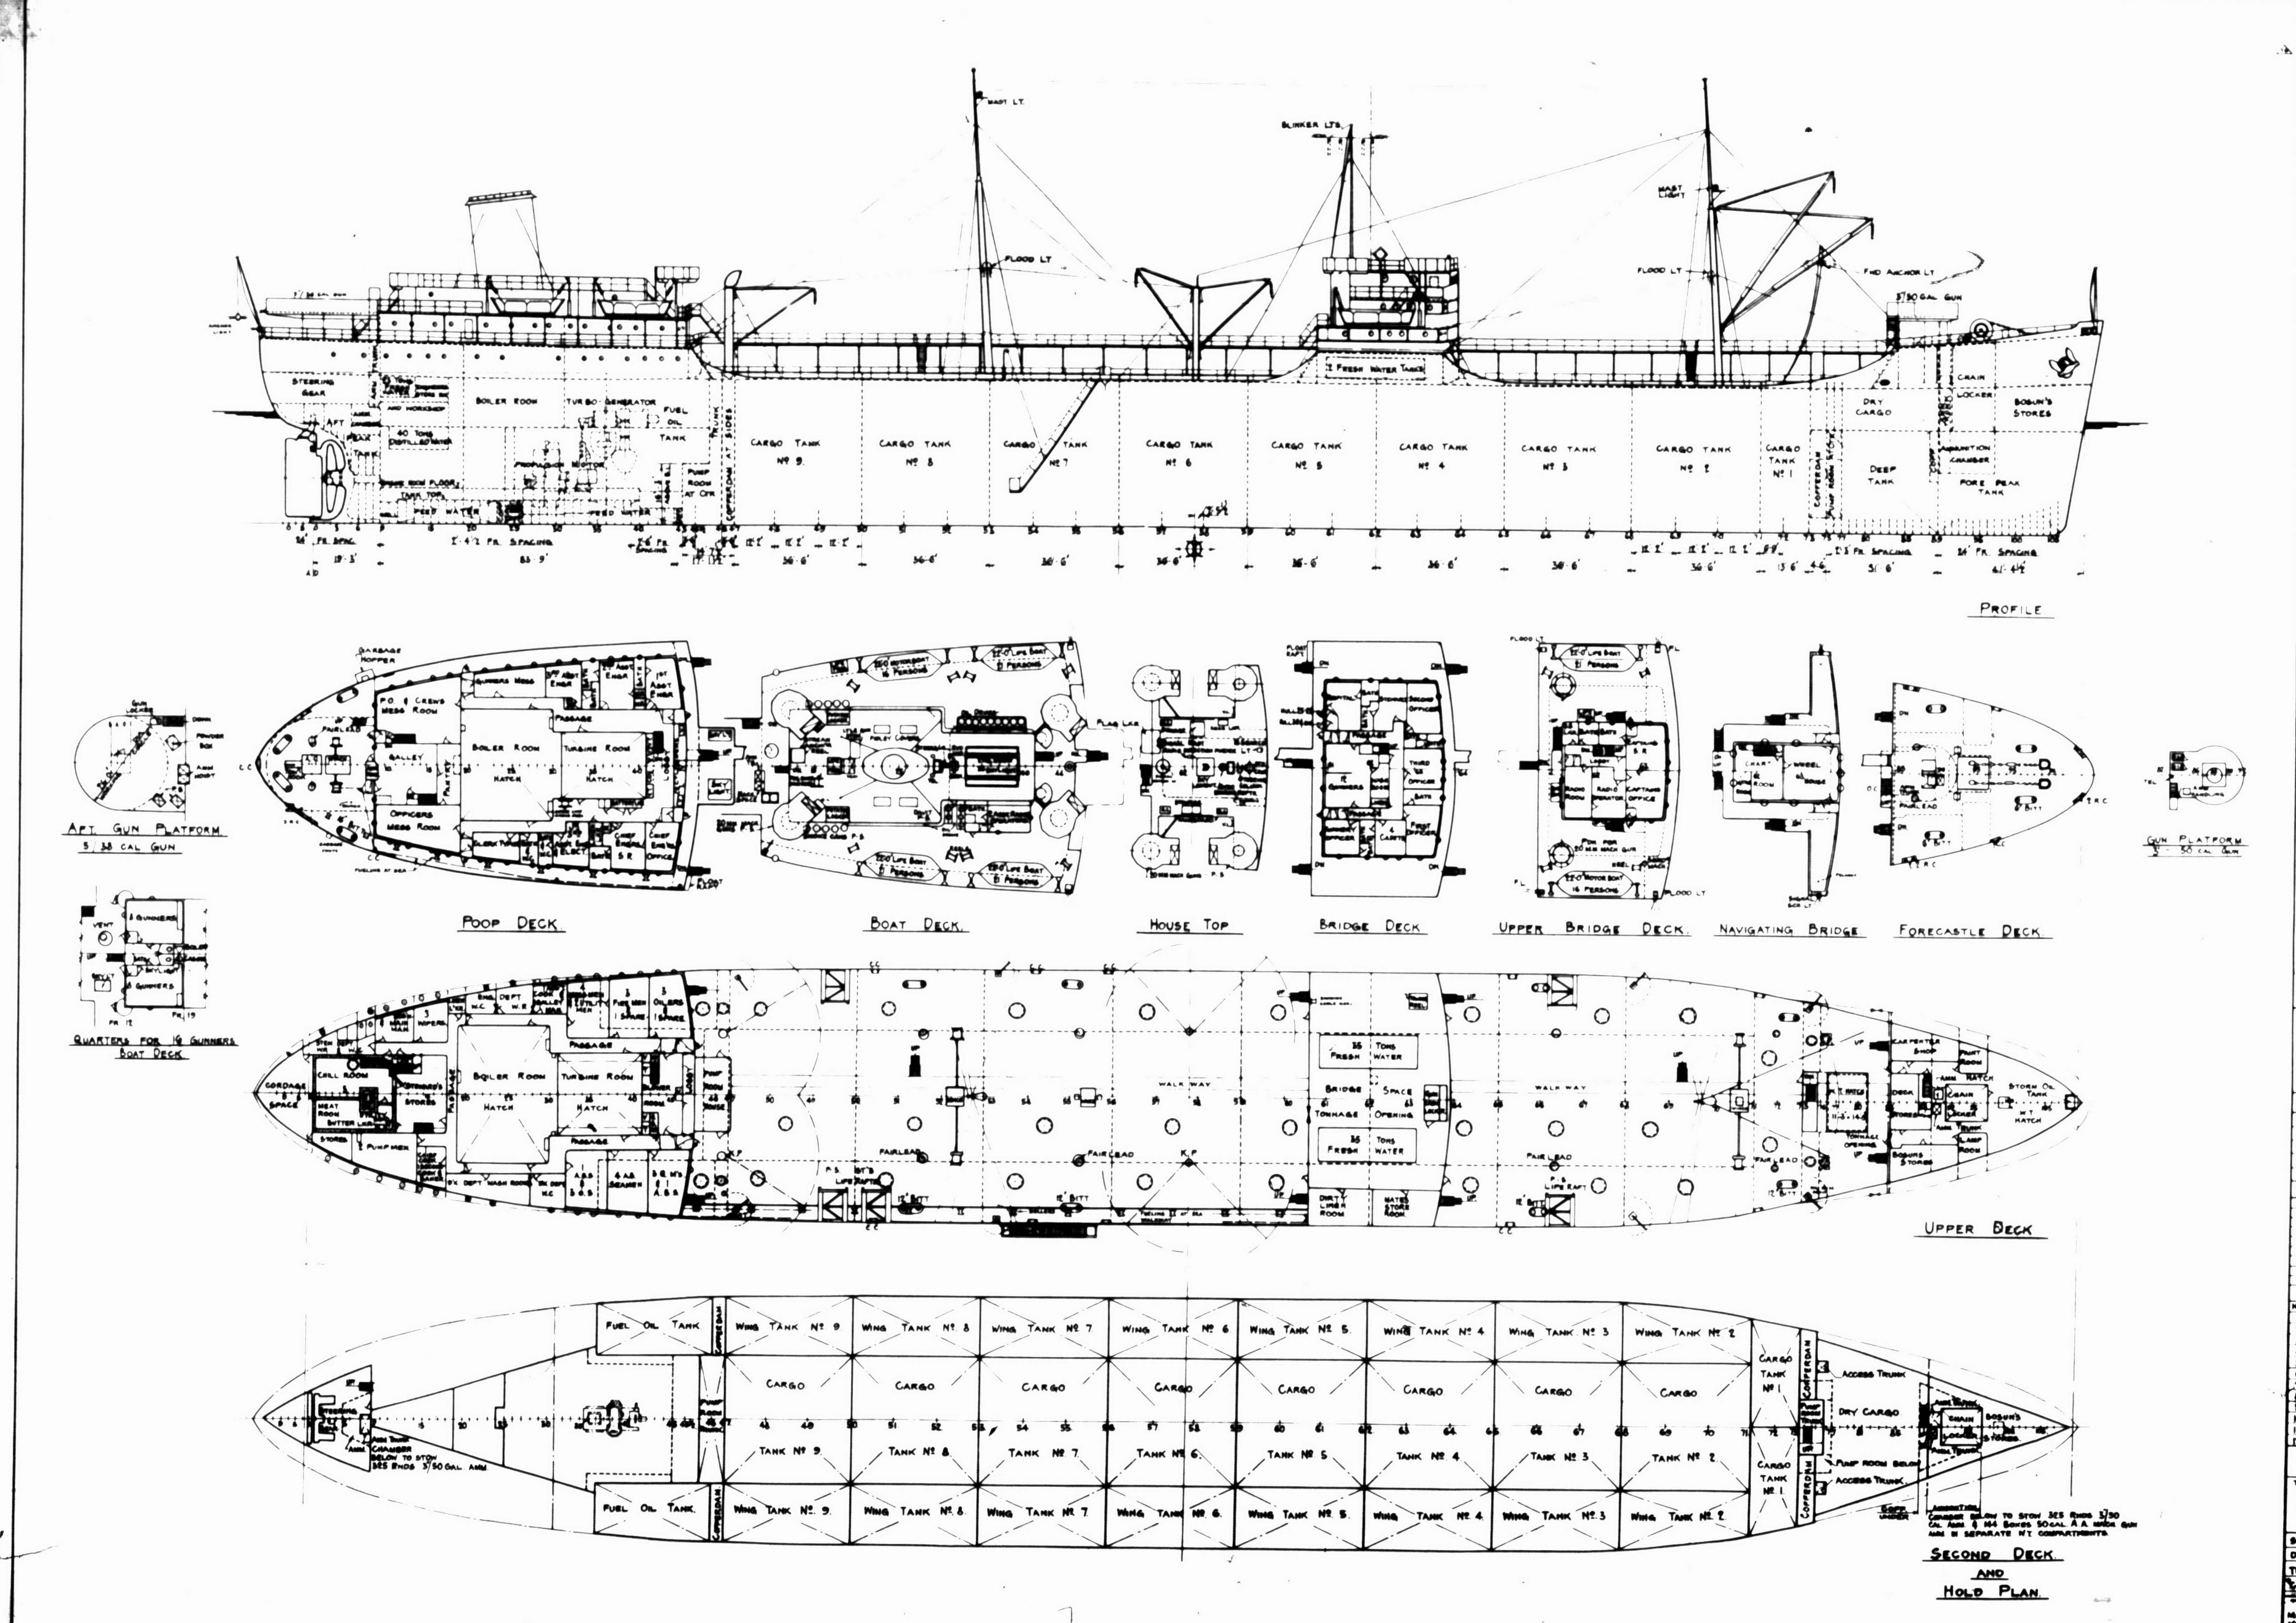

PROFILE
MAST LT.
BLINKER LTS.
MAST LIGHT
FLOOD LT
FWD ANCHOR LT
5"/38 CAL GUN
3"/50 CAL GUN
STEERING GEAR
BOILER ROOM
TURBO GENERATOR
FUEL OIL TANK
40 TONS DISTILLED WATER
PROPULSION MOTOR
FEED WATER
PUMP ROOM
COFFERDAM
CARGO TANK Nº 9
CARGO TANK Nº 8
CARGO TANK Nº 7
CARGO TANK Nº 6
CARGO TANK Nº 5
CARGO TANK Nº 4
CARGO TANK Nº 3
CARGO TANK Nº 2
CARGO TANK Nº 1
FRESH WATER TANK
DRY CARGO
DEEP TANK
CHAIN LOCKER
BOSUN'S STORES
AMMUNITION CHAMBER
FORE PEAK TANK
FR. SPACING
AFT GUN PLATFORM
5" 38 CAL GUN
POOP DECK
P.O. & CREWS MESS ROOM
GALLEY
OFFICERS MESS ROOM
BOILER ROOM HATCH
TURBINE ROOM HATCH
PASSAGE
BOAT DECK
LIFE BOAT
PERSONS
HOUSE TOP
BRIDGE DECK
UPPER BRIDGE DECK
RADIO OPERATOR
CAPTAINS OFFICE
NAVIGATING BRIDGE
CHART ROOM
WHEEL HOUSE
FORECASTLE DECK
GUN PLATFORM
3" 50 CAL GUN
QUARTERS FOR 16 GUNNERS
BOAT DECK
GUNNERS
UPPER DECK
CORDAGE SPACE
CHILL ROOM
MEAT ROOM
BUTTER LOCKER
STORES
PUMPMEN
WALK WAY
35 TONS FRESH WATER
BRIDGE SPACE
TONNAGE OPENING
FAIRLEAD
DIRTY LINEN ROOM
MATES STORE ROOM
CARPENTER SHOP
BOSUN'S STORES
STORM OIL TANK
SECOND DECK AND HOLD PLAN
FUEL OIL TANK
WING TANK Nº 9
WING TANK Nº 8
WING TANK Nº 7
WING TANK Nº 6
WING TANK Nº 5
WING TANK Nº 4
WING TANK Nº 3
WING TANK Nº 2
CARGO
TANK Nº 9
TANK Nº 8
TANK Nº 7
TANK Nº 6
TANK Nº 5
TANK Nº 4
TANK Nº 3
TANK Nº 2
CARGO TANK Nº 1
COFFERDAM
ACCESS TRUNK
DRY CARGO
PUMP ROOM BELOW
AMMUNITION CHAMBER BELOW TO STOW 325 RNDS 3"/50 CAL AMM
AMMUNITION CHAMBER BELOW TO STOW 325 RNDS 3"/50 CAL AMM & 144 BOXES 50 CAL A.A. MACH GUN AMM IN SEPARATE WT COMPARTMENTS

ALTERATIONS

Nº	PANEL	DESCRIPTION	BY	CK	APP	U.S.M.C. DATE	APP
△1	ALL	DWG 103-1 WAS REDRAWN AND REVISED INCLUDING THE FOLLOWING CHANGES: ADDED PROFILE: HOUSE FOR 2 ASSISTANT RADIO OPERATORS AND PIPE RAILING OVER POOP DK: GARBAGE CHUTE AFT. [illegible] IN STBD PASSAGE. ONE AIRPORT EACH ROOM, CHIEF AND 2 & 3 OFC & 1ST ASST ENG HOUSE TOP: SIGNAL SEARCH LT PLATFORM [illegible] LIGHT BRIDGE DK: AIRPORT GUNNERY OFCR S.R. UPPER BR DK: AIRPORT TO CAPTAINS OFC UPPER DK: ONE AIRPORT EACH ROOM FOR 3 [illegible] STBD & 3 OILERS PORT. BONDING CABLE REEL IN BRIDGE SPACE. FUELING AT SEA WALKWAY, BET AFT HOUSE AND BRIDGE SPACE HOUSE, STBD SIDE DELETED PROFILE: RADIO ANTENNA ON MAIN MAST & [illegible] ON HOUSE TOP. 2 FORESTAYS HOUSE TOP: PLASTIC DECK COVERING UPPER DK: AIRPORT IN CORDAGE SPACE CHANGED PROFILE: SPLINTER SHIELDS AT 5" GUN AND 20 MM MACHINE GUNS BOAT DK: RELOCATED GEAR LOCKERS [illegible] GUN TUBS AT FR 12. BOILER ROOM VENT COWL. ENGINE ROOM SKYLIGHT. 20 MM MACH GUN TUBS SPLINTER SHIELDS BRIDGE DK: BLACKOUT CURTAINS UPPER BR DK: BLACKOUT CURTAINS NAV BR DK: PELORUS LOCATIONS UPPER DK: BLACKOUT CURTAINS AFT. LOCATION OF UNDER PLATFORM & DAVITS FOR ACCOMODATION LADDER	ASM	★	7/4		

APPROVED AS NOTED
M C E LETTER DATED 3/ /44 ABS LETTER
M C E FILE NO 1859 S33
BY Signed H L St Clair BMIN LETTER
BY

PRINCIPAL DIMENSIONS

LENGTH OVERALL	523'-6"
LENGTH BET PERPS	503'-0"
BEAM MOULDED	68'-0"
DEPTH-MOULDED	39'-3"
DRAFT MOULDED	29'-11¼"

PRINTS ISSUED

ENG FILES	RIGGING DEPT	SHEET METAL SHOP
NAVAL ARCHITECT	WELDER	MARINE ELECTRIC
PLANT DIVISION	WELDING CONSULTANT	U S M C
PLANNING	BUILDING WAYS	A. B. S.
INSPECTION	OUTFITTING MGR	U.S.C.G.
MOLD LOFT	OUTFITTING DOCKS	FIELD ENGINEER
PRODUCTION CONTROL	SHIPWRIGHT	CHIEF DRAFTSMAN
MATERIAL ENG	SUPT MACHINERY	MODEL SHOP
PLATE SHOP	PIPE SHOP	

REFERENCES

Nº	TITLE	DRAWING Nº
1	GENERAL ARRGT QTRS AFT - ¼" SCALE	S-3304-1
2	" " " FWD - " "	S-3304-2
3		
4		
5		
6		
7		
8		
9		
10		
11		
12		

MARINSHIP CORPORATION
SAUSALITO, CALIF.

TITLE:-
GENERAL ARRANGEMENT PLAN.

SCALE 1/16" = 1 FOOT	DATE July 4-1944
DRAWN	APPROVED
TRACED R. E. FULTON	APPROVED
CHECKED	APPROVED

HULL NO
M.C. 1822 - 1825
YARD 46 - 49

MARINSHIP FILE Nº △1
T2-S103-1

S1-3-1

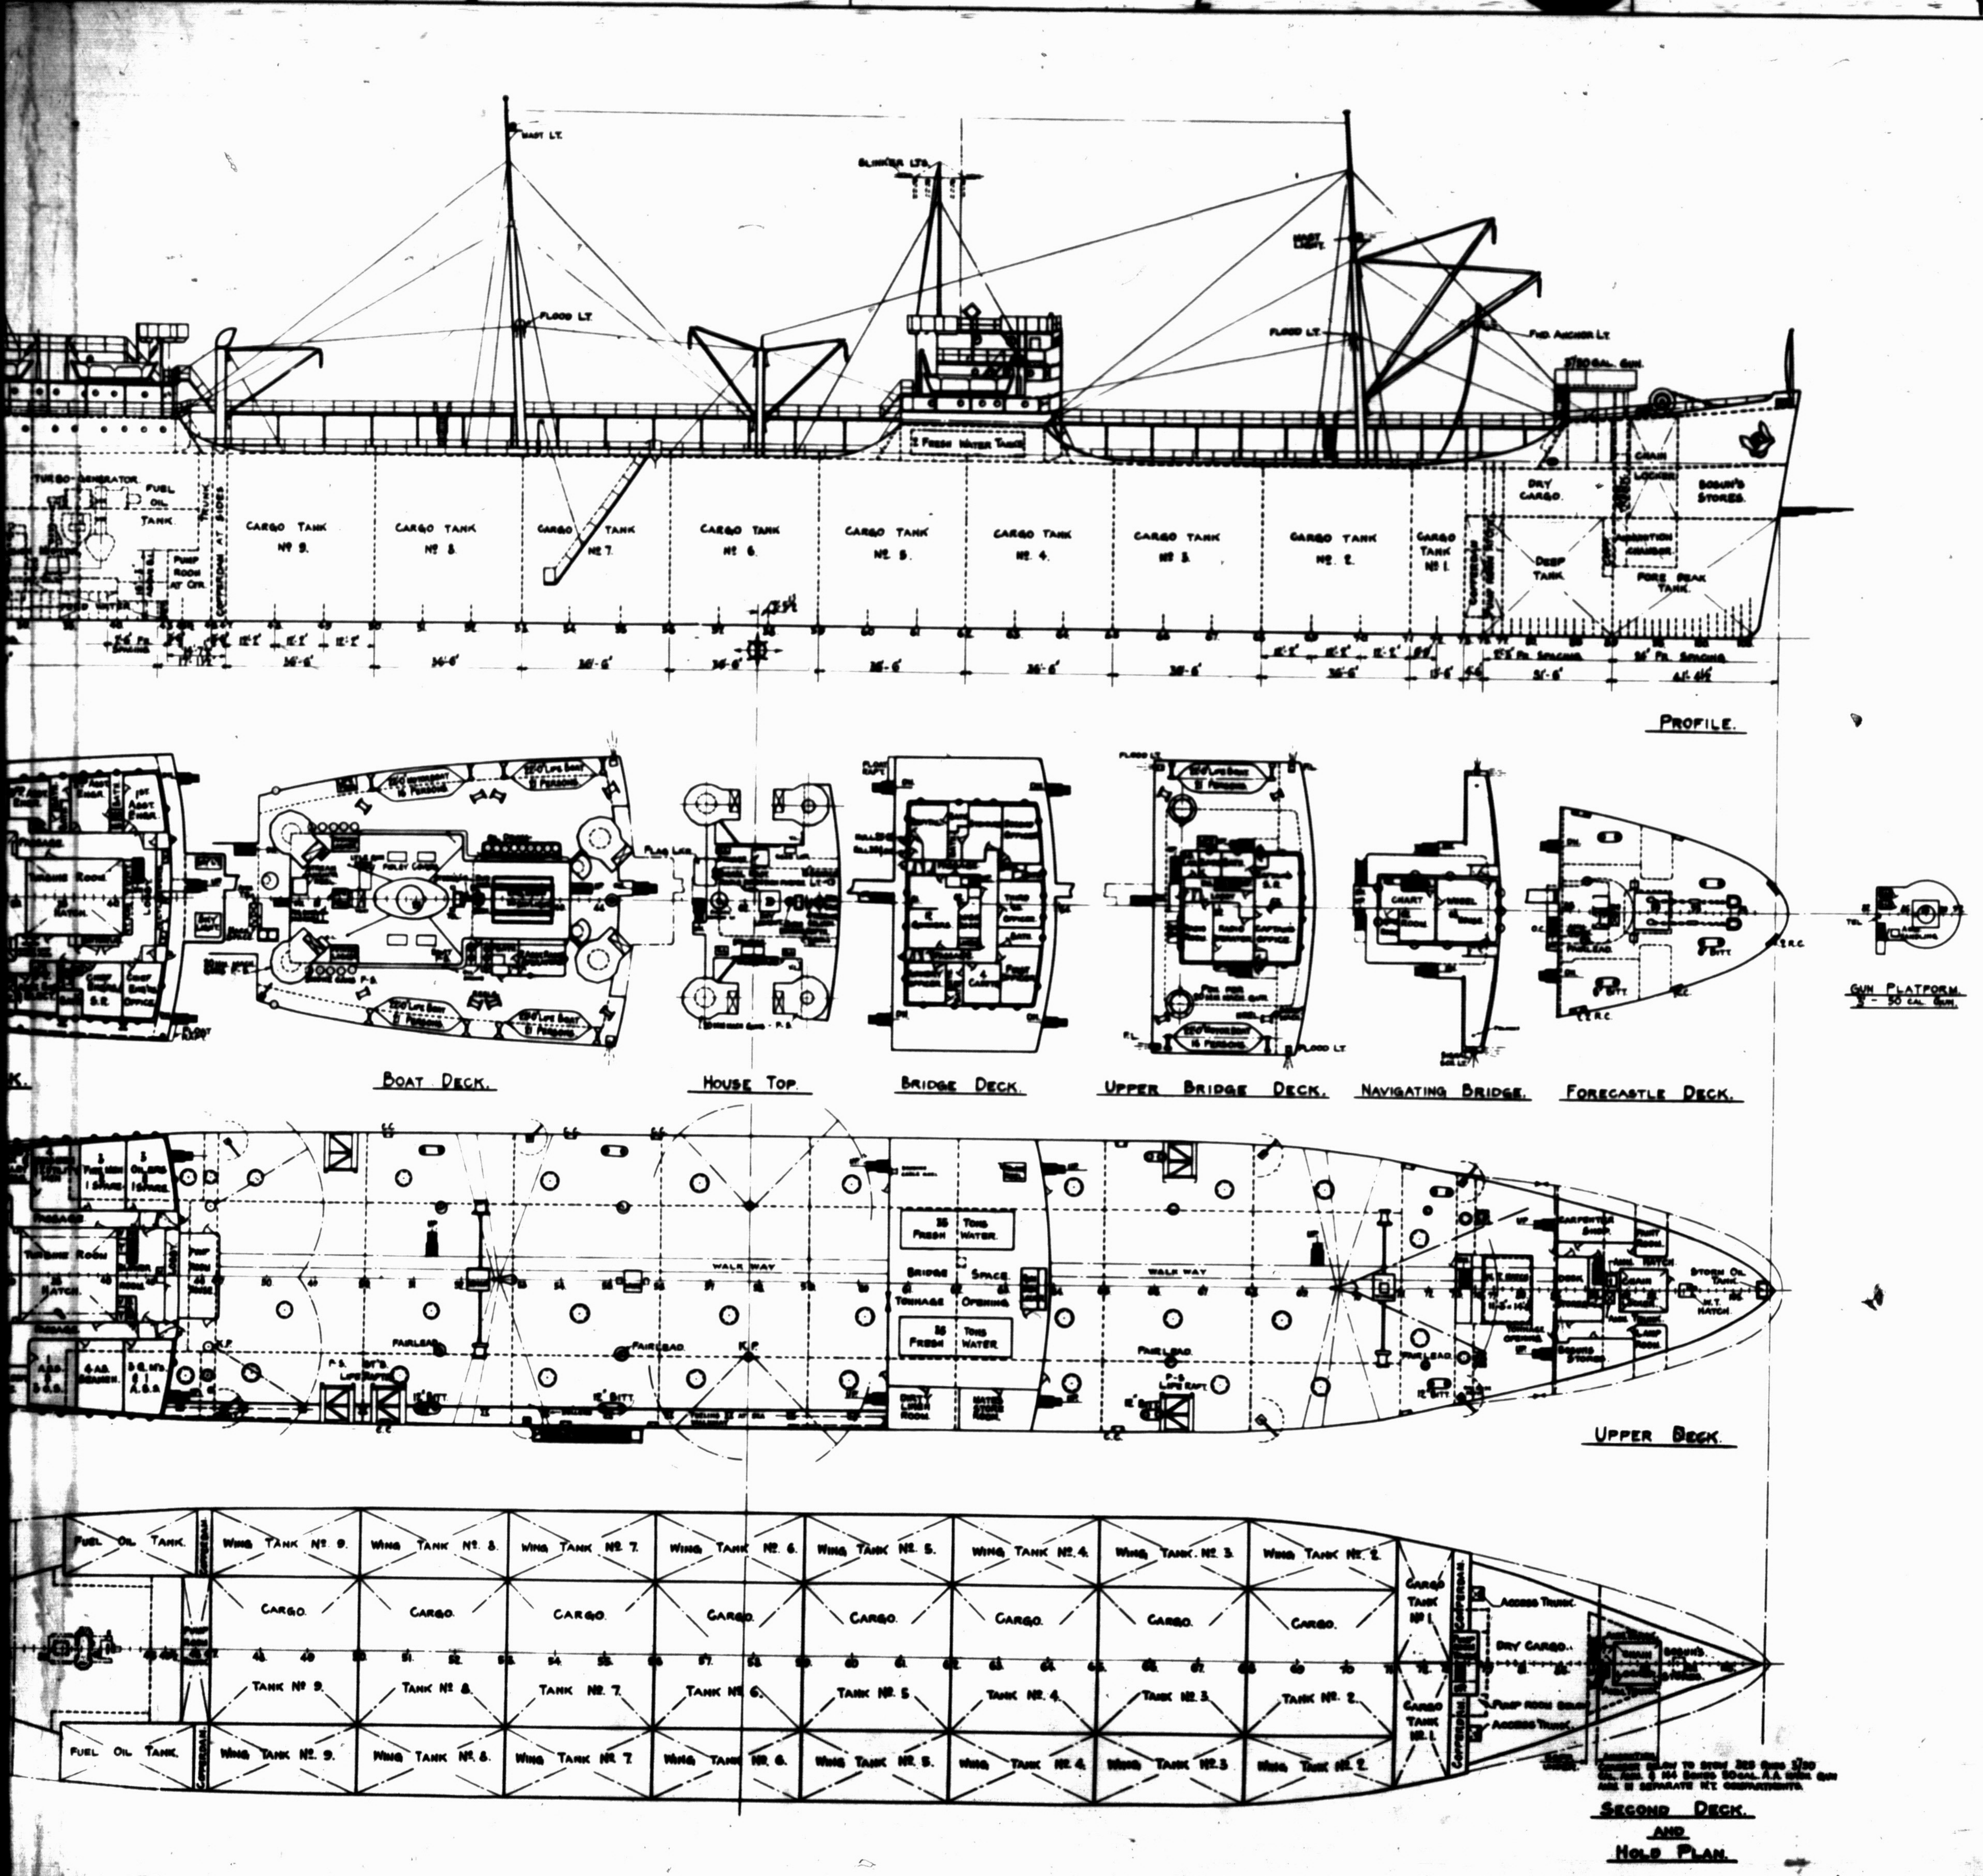

3
2
1
PROFILE.
CARGO TANK Nº 9.
CARGO TANK Nº 8.
CARGO TANK Nº 7.
CARGO TANK Nº 6.
CARGO TANK Nº 5.
CARGO TANK Nº 4.
CARGO TANK Nº 3.
CARGO TANK Nº 2.
CARGO TANK Nº 1.
DRY CARGO
DEEP TANK
FORE PEAK TANK
BOSUN'S STORES
CHAIN LOCKER
FUEL OIL TANK
TURBO-GENERATOR
PUMP ROOM
MAST LT.
FLOOD LT.
BLINKER LTS.
MAST LIGHT
FWD. ANCHOR LT.
FRESH WATER TANK
BOAT DECK.
HOUSE TOP.
BRIDGE DECK.
UPPER BRIDGE DECK.
NAVIGATING BRIDGE.
FORECASTLE DECK.
GUN PLATFORM
CHART
UPPER DECK.
WALK WAY
FRESH WATER
BRIDGE SPACE
TONNAGE OPENING
FAIRLEAD
STORM OIL TANK
SECOND DECK AND HOLD PLAN.
FUEL OIL TANK
WING TANK Nº 9.
WING TANK Nº 8.
WING TANK Nº 7.
WING TANK Nº 6.
WING TANK Nº 5.
WING TANK Nº 4.
WING TANK Nº 3.
WING TANK Nº 2.
CARGO
TANK Nº 9.
TANK Nº 8.
TANK Nº 7.
TANK Nº 6.
TANK Nº 5.
TANK Nº 4.
TANK Nº 3.
TANK Nº 2.
CARGO TANK Nº 1
COFFERDAM
ACCESS TRUNK
DRY CARGO
PUMP ROOM

ALTERATIONS.

Nº	PANEL	DESCRIPTION.	BY	CK	APPROVED	[illegible]	[illegible]
1	ALL	[illegible] ADDED [illegible] DELETED [illegible] CHANGED [illegible]					

APPROVED AS NOTED. ALT 12
M.C.E. LETTER DATED 3-11-44 A.B.S LETTER
M.C.E. FILE NO. 1859-S33-1-1
BY Signed H.E. St Clair B.M.I.N. LETTER
BY

PRINCIPAL DIMENSIONS.

LENGTH OVERALL	523'-6"
LENGTH BET. PERPS	503'-0"
BEAM-MOULDED	68'-0"
DEPTH-MOULDED	39'-3"
DRAFT MOULDED	29'-11½"

ALT.

PRINTS ISSUED.

ENG. FILES		RIGGING DEPT		SHEET METAL SHOP	
NAVAL ARCHITECT		WELDER		MARINE ELECTRIC	
PLANT DIVISION		WELDING CONSULTANT		U.S.M.C.	
PLANNING		BUILDING WAYS.		A.B.S.	
INSPECTION		OUTFITTING MGR.		U.S.C.G.	
MOLD LOFT		OUTFITTING DOCKS.		FIELD ENGINEER.	
PRODUCTION CONTROL		SHIPWRIGHT.		CHIEF DRAFTSMAN	
MATERIAL ENG		SUPT. MACHINERY		MODEL SHOP	
PLATE SHOP		PIPE SHOP			

REFERENCES.

NO.	TITLE.	DRAWING Nº.
1	GENERAL ARRGT - QTRS AFT - ¼" SCALE	S-3304-1
2	" " " FWD " " "	S-3304-2
3		
4		
5		
6		
7		
8		
9		
10		
11		
12		

MARINSHIP CORPORATION.
SAUSALITO, CALIF.

TITLE:-
GENERAL ARRANGEMENT PLAN.

SCALE	1/16" = 1 FOOT.	DATE.	July 4-1944
DRAWN.		APPROVED.	
TRACED.	R. E. FULTON.	APPROVED.	
CHECKED.		APPROVED.	

	HULL NO.
MC.	1622 - 1625
YARD.	46 - 49

MARINSHIP FILE Nº
T2-S103-1.

S1-3-1